

# RECORD OF SURVEY NO. 34-11

IN THE SW 1/4 OF SEC 9, T1N, R26E, MDB&M,  
MONO COUNTY, CALIFORNIA

## SURVEYOR'S CERTIFICATE

This map correctly represents a survey made by me or under my direction in conformance with the requirements of the Land Surveyor's Act at the request of Mario G. & Jan V. Barsi in October, 1980.

*John R. Langford*  
RCE #7104  
COUNTY SURVEYOR

## COUNTY SURVEYOR'S CERTIFICATE


This map has been examined for conformance with the requirements of the Land Surveyor's Act this 6th day of February 1981.

*John R. Langford*  
County Surveyor

## RECORDER'S CERTIFICATE

Filed this 9th day of February, 1981, at 2:04 p.m. in Book 7 of Record Survey at page 64, at the request of Mario G. & Jan V. Barsi. #6313

*John R. Langford*  
County Recorder

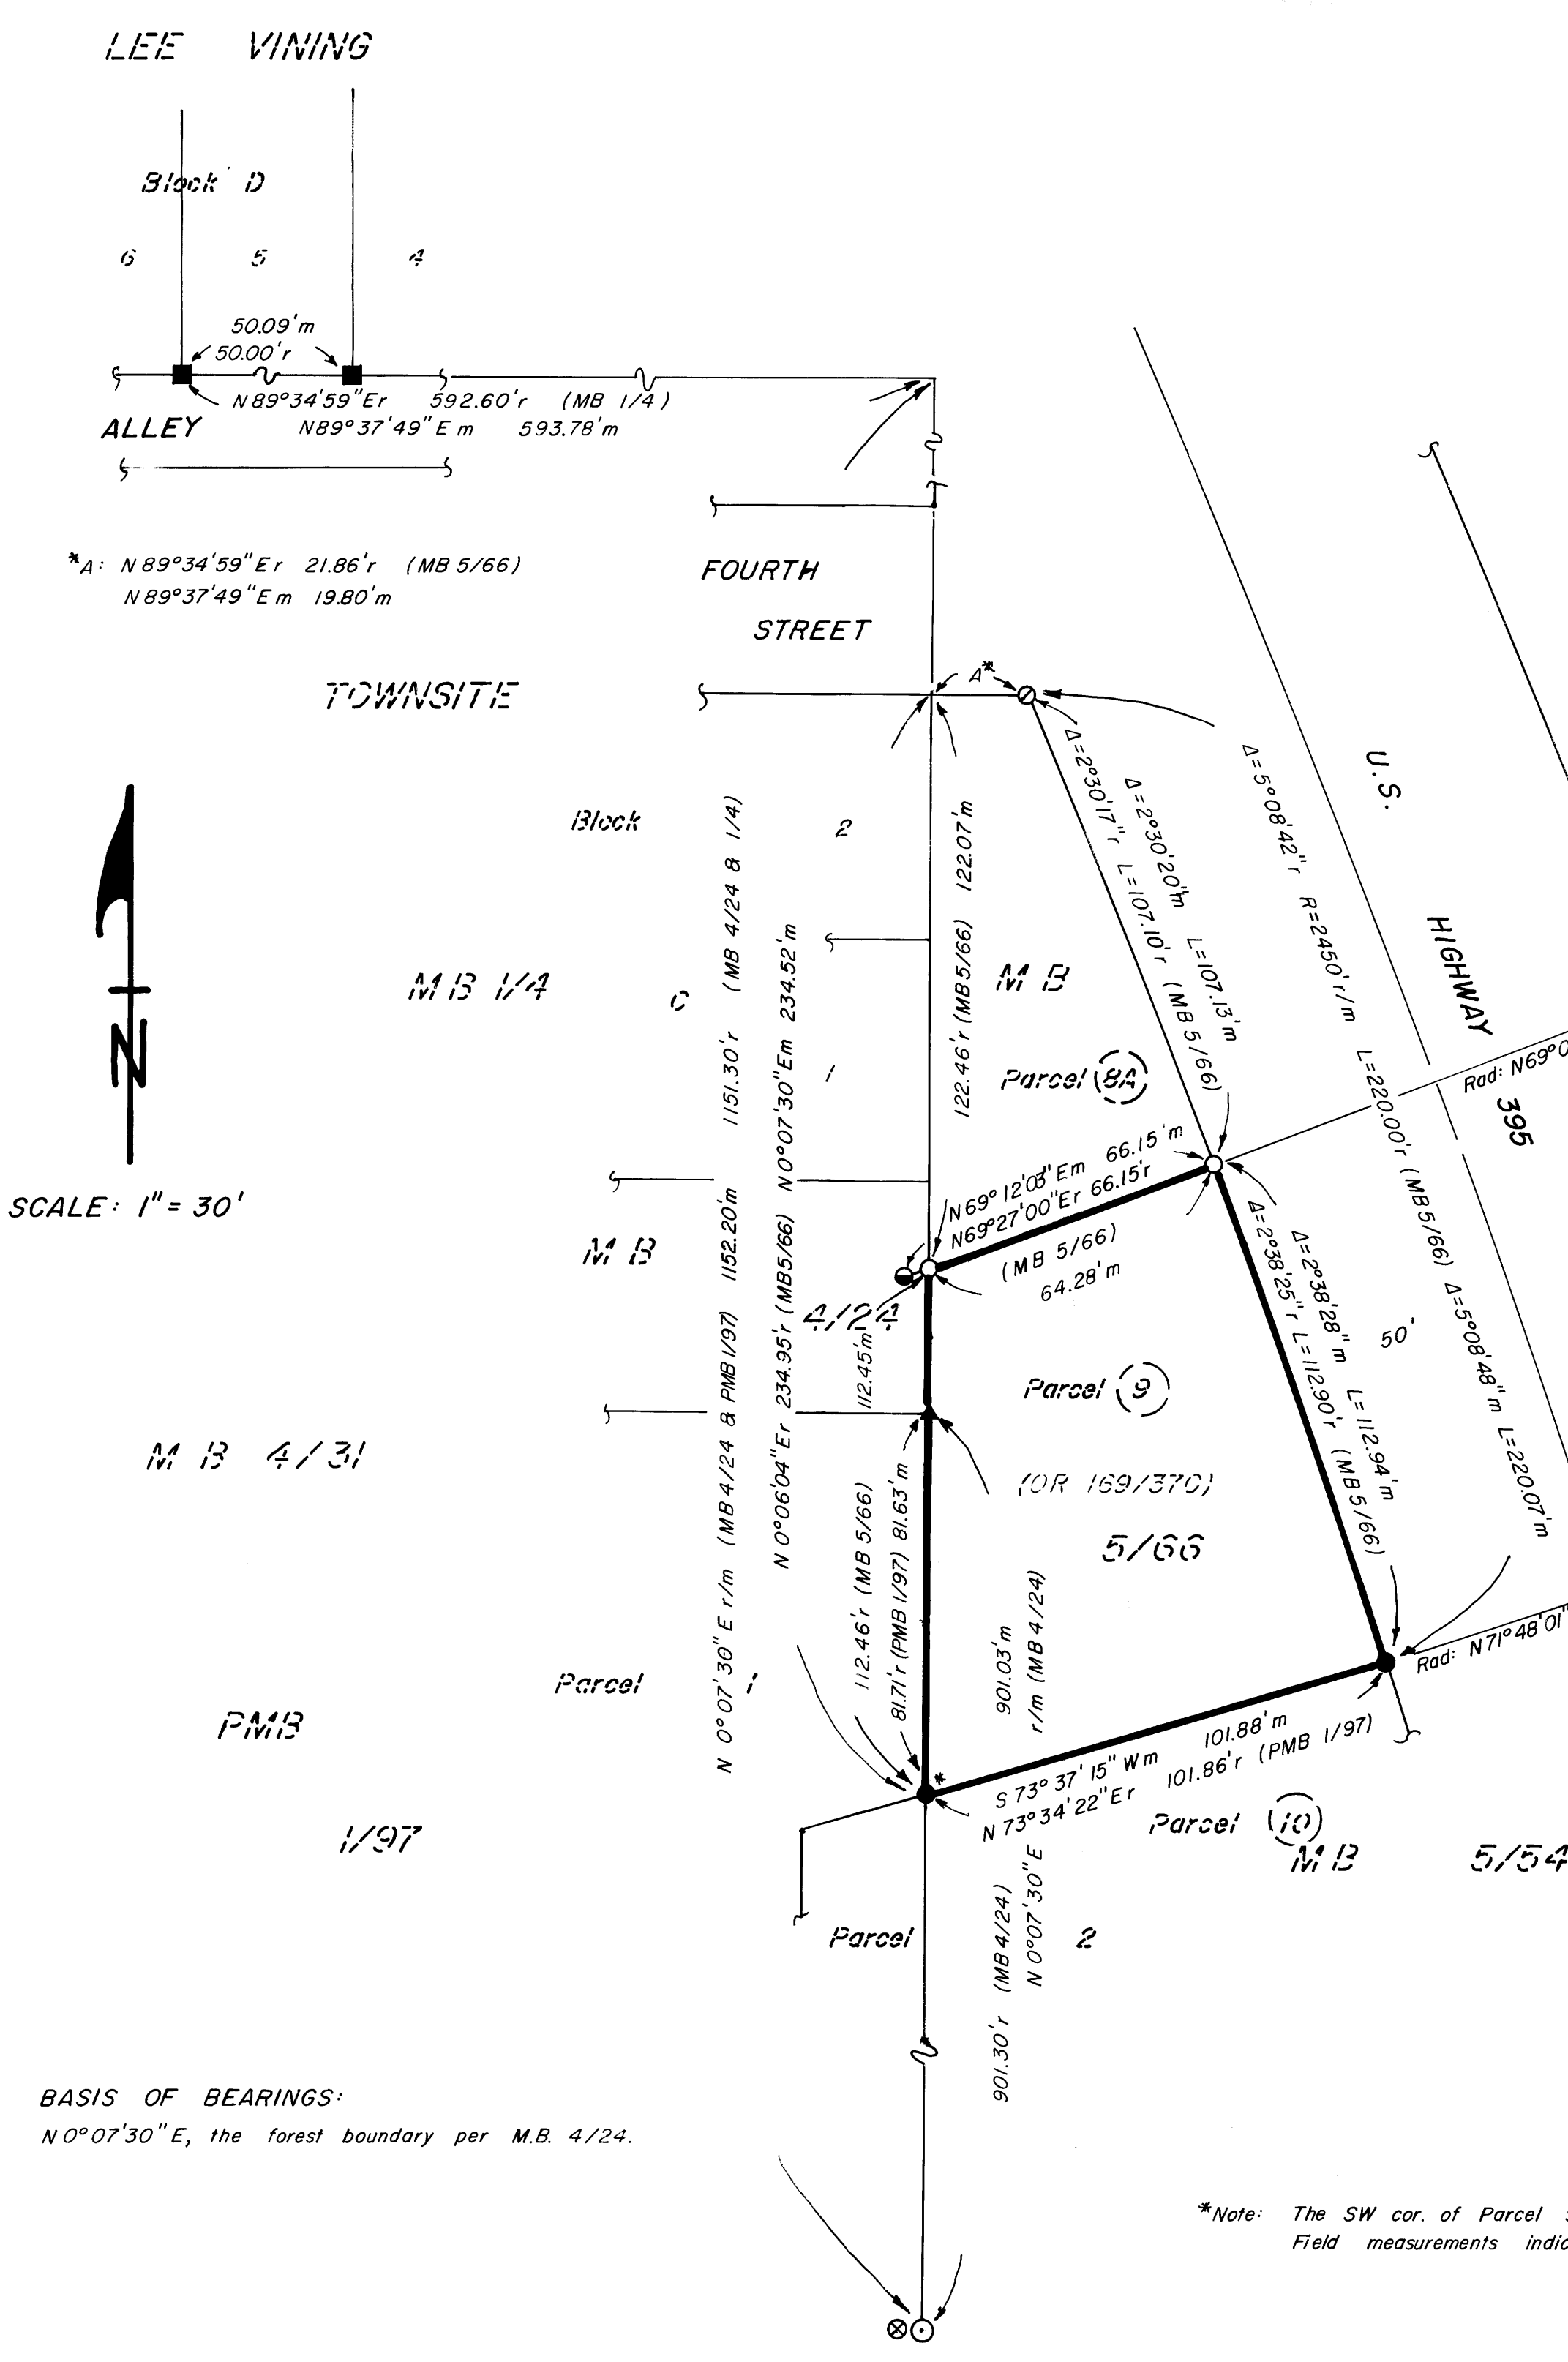

## LEGEND:

- Found 2" I.D. I.P. & tag RCE 10467. Accepted as 1/16 cor. Sec. 9 per MB 4/24 & PMB 1/97.
- ⊗ Found 4"x4" wood post & tag RCE 7211 per MB 5/122. Post is 0.7' W of 2" pipe. Pipe was set prior to post. Record information indicates that Lee Vining Townsite was established from pipe.
- Found 3/4" I.D. I.P. & tag RCE 10467. Accepted per PMB 1/97.
- ▲ Found 'T' bar 1' below grade in 3" I.D. galv. pipe. Accepted per MB 4/24.
- Set 1" I.D. I.P. & tag RCE 27104.
- Found 3/4" I.D. I.P. per MB 5/66. Pipe is 2' W of Forest Boundary per MB 4/24. Lot corner reset on Forest Boundary.
- Found bent 3/4" I.D. I.P. at edge of concrete curb return. Accepted per MB 5/54.
- Found 15"x15"x6' rock pillar with iron rod. George LaBraque, owner of Lot 5, Block D, MB 1/4, stated that he had constructed pillars and had centered iron rods over 2"x2" hubs, the original lot corner monuments. Accepted as lot corners.

SCALE: 1" = 30'

BASIS OF BEARINGS:  
N 0° 07' 30" E, the forest boundary per M.B. 4/24.

r Based on record information.  
m Based on measured information.  
r/m Based on record & measured information.

\*Note: The SW cor. of Parcel 9 was originally set per MB 5/54. Field measurements indicate that the cor. was reset per PMB 1/97.

MS Vol 7 Page 64